


REFLECTIVE SOUND SCREENS  
HEIGHTS: 1050 - 1250 - 1550 - 1850mm



AUGUST 2014

- PLEASE NOTE:
- STRUCTURAL CALCULATIONS MAY BE REQUIRED BY QUALIFIED PERSONS. NO RESPONSIBILITY CAN BE ACCEPTED BY USING THIS DESIGN WITHOUT PROFESSIONAL ADVICE.
  - DESIGN IN ACCORDANCE WITH SPECIFICATION FOR HIGHWAY WORKS CLAUSE 2504. TREATMENT TO SECTOR SCHEME 4.
  - REFLECTIVE SOUND SCREEN FITTED TO TIMBER POSTS (FOR ILLUSTRATION PURPOSES ONLY). STEEL POSTS CAN BE AN ALTERNATIVE.
  - HEIGHT OF SOUND SCREEN VARIABLE TO SUIT SPECIFIC LOCATIONS. POST CENTRES AT 3.0M UNLESS OTHERWISE SPECIFIED.
  - CONFORMS AND TESTED TO BS EN 1793. ALSO TESTED AND COMPLIES TO BS EN 1794-1 AND BS EN 1794-2.
  - COMPLIES WITH HIGHWAYS SECTOR SCHEME 2C FOR THE PREFABRICATION OF ENVIRONMENTAL BARRIERS.
  - AVERAGE DENSITY 36.4 KG/M<sup>3</sup> (EXCLUDING POSTS).



HALES, MARKET DRAYTON  
SHROPSHIRE, TF9 3PP  
TEL: 01630 653359  
FAX: 01630 658859  
www.halesawmills.co.uk

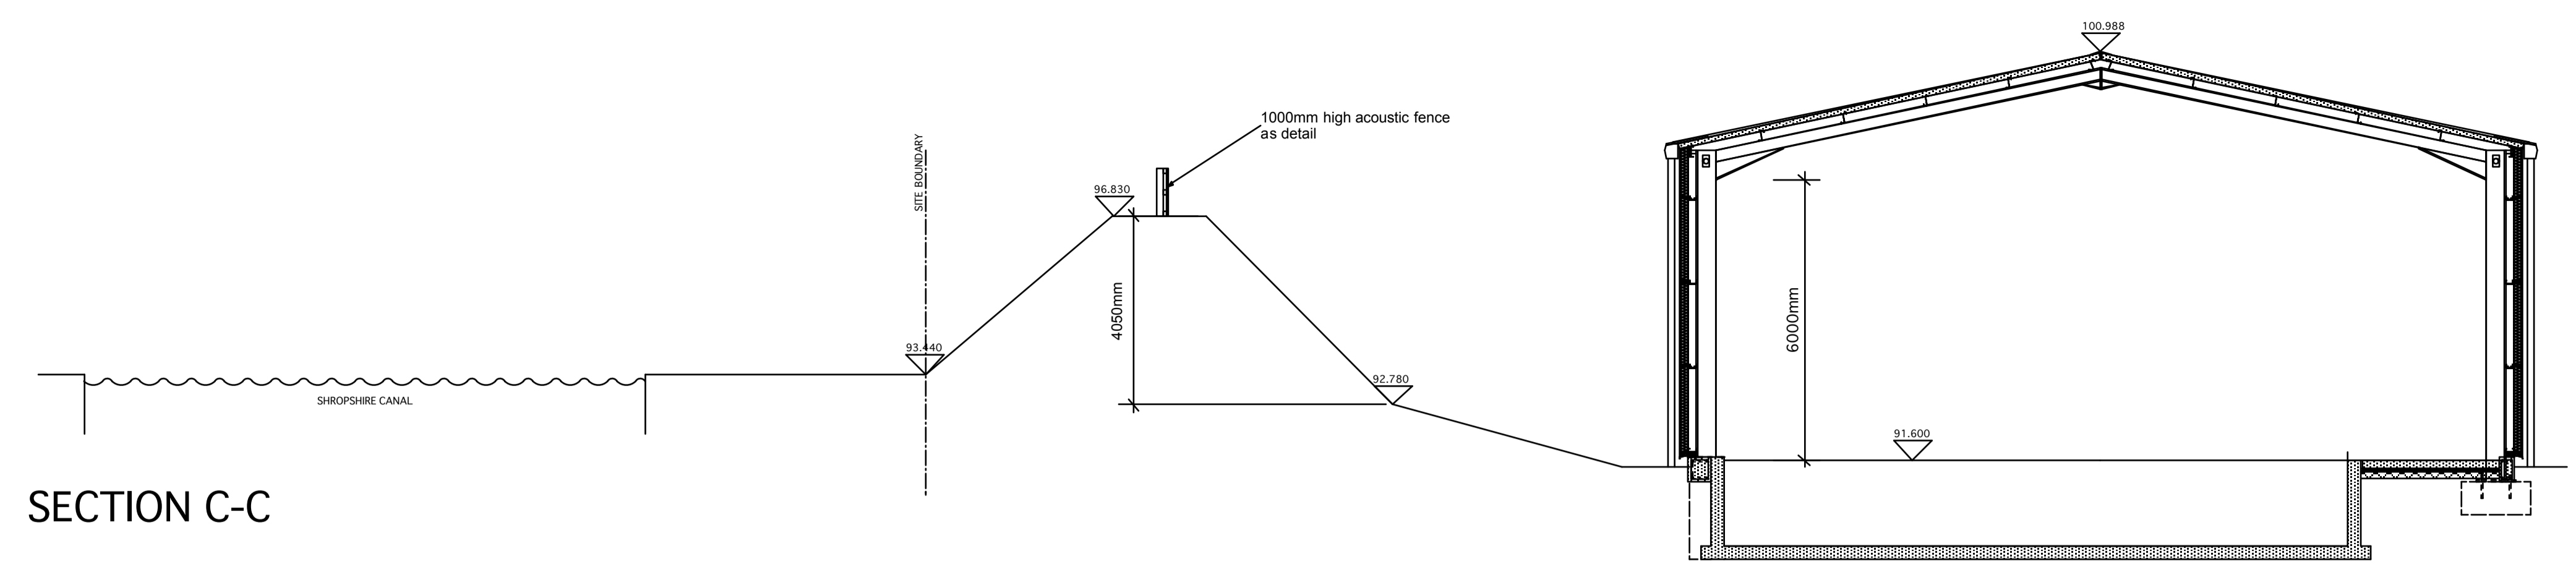


SECTION C-C

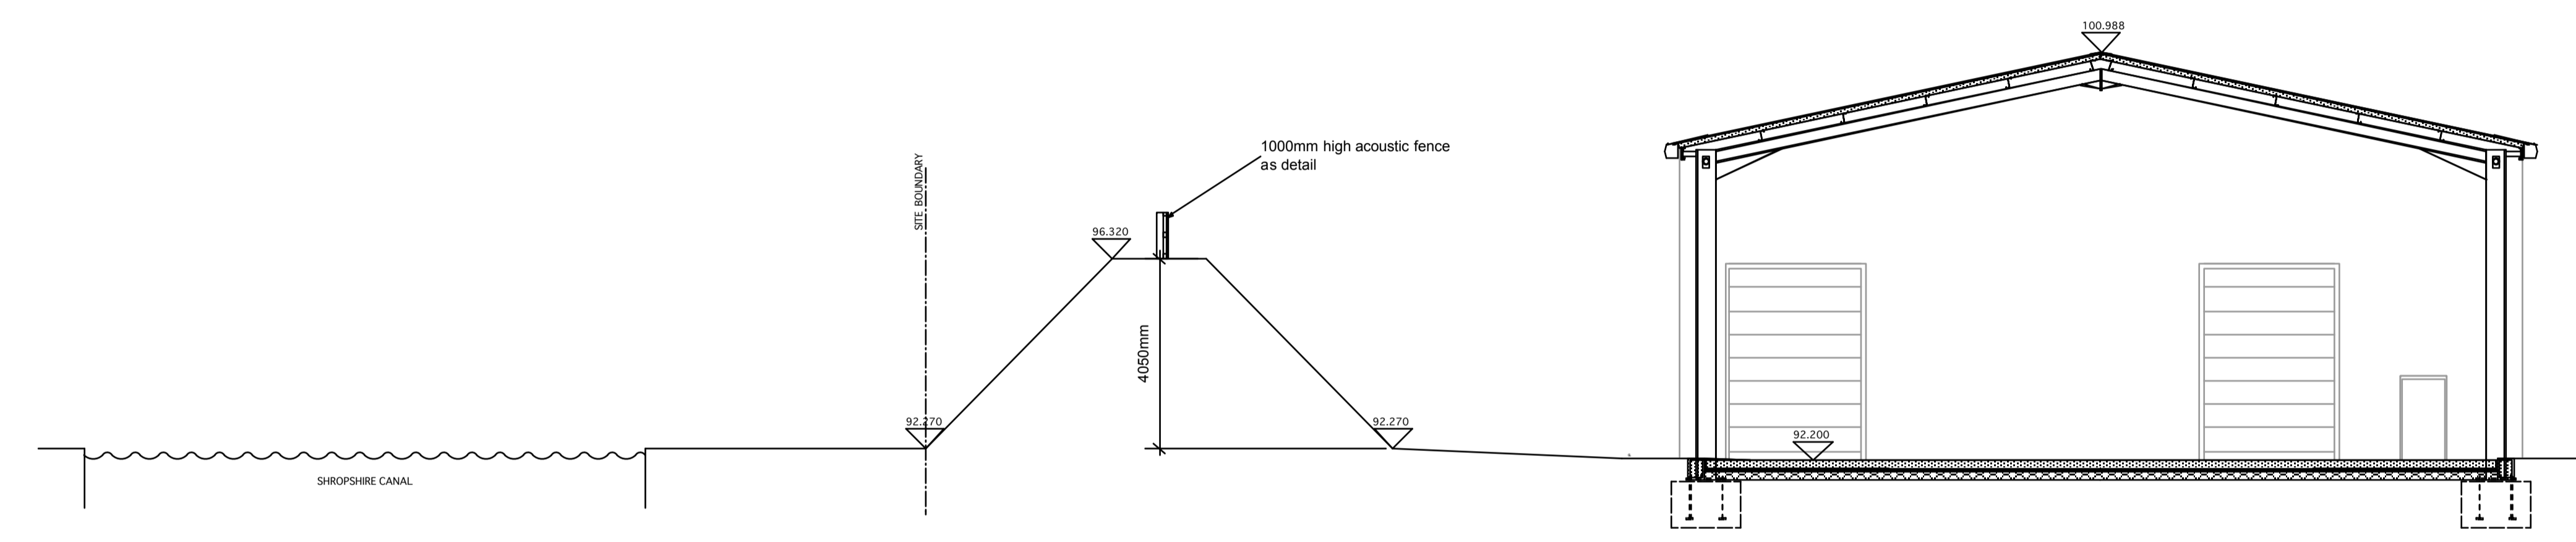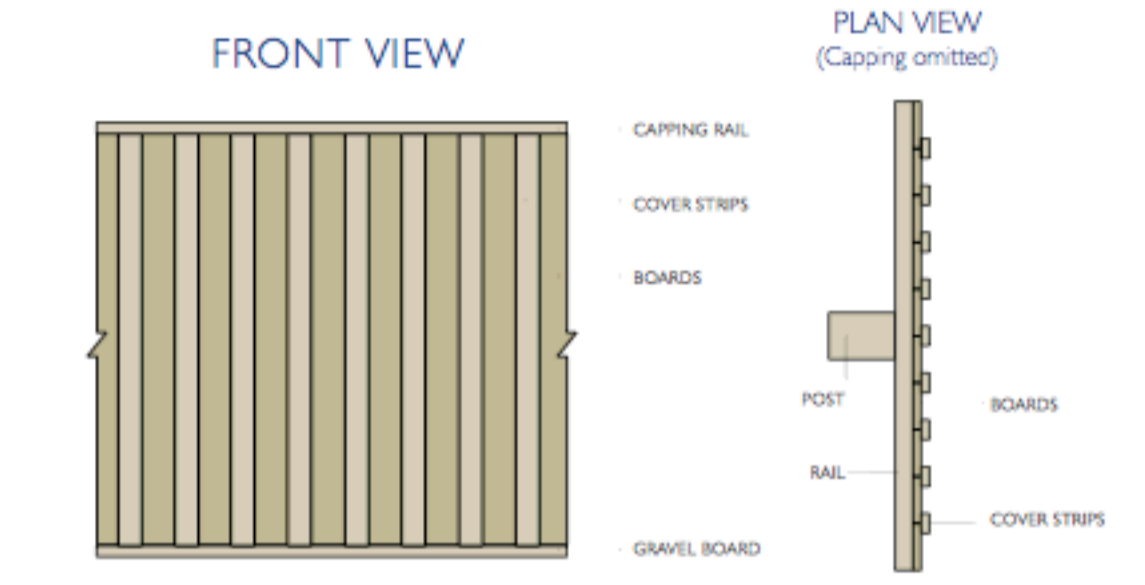

SECTION B-B

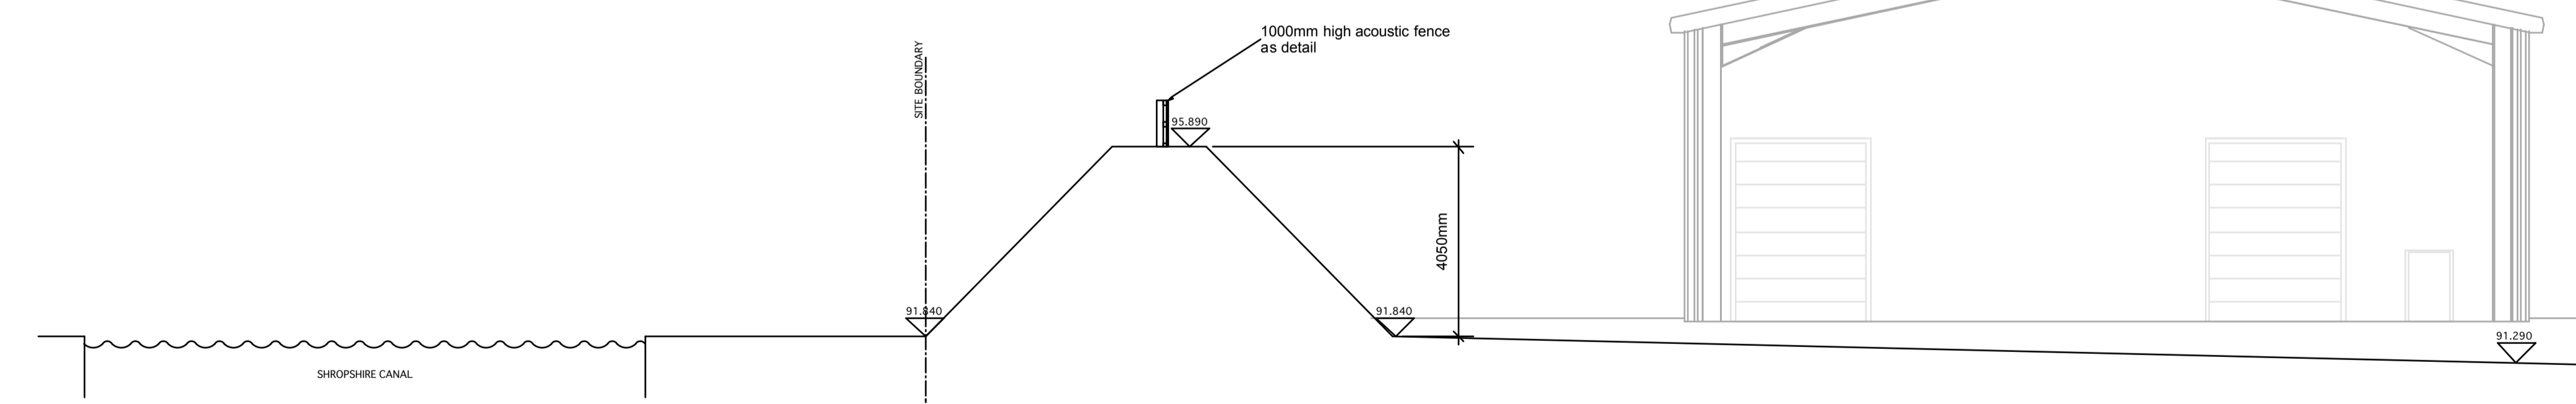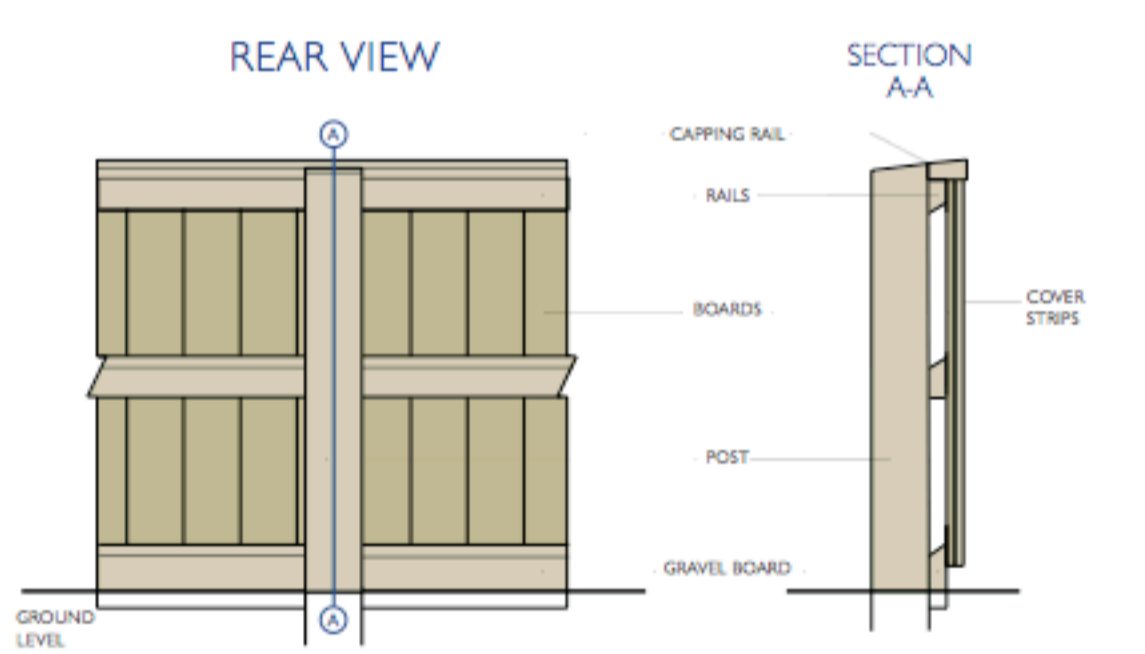

SECTION A-A

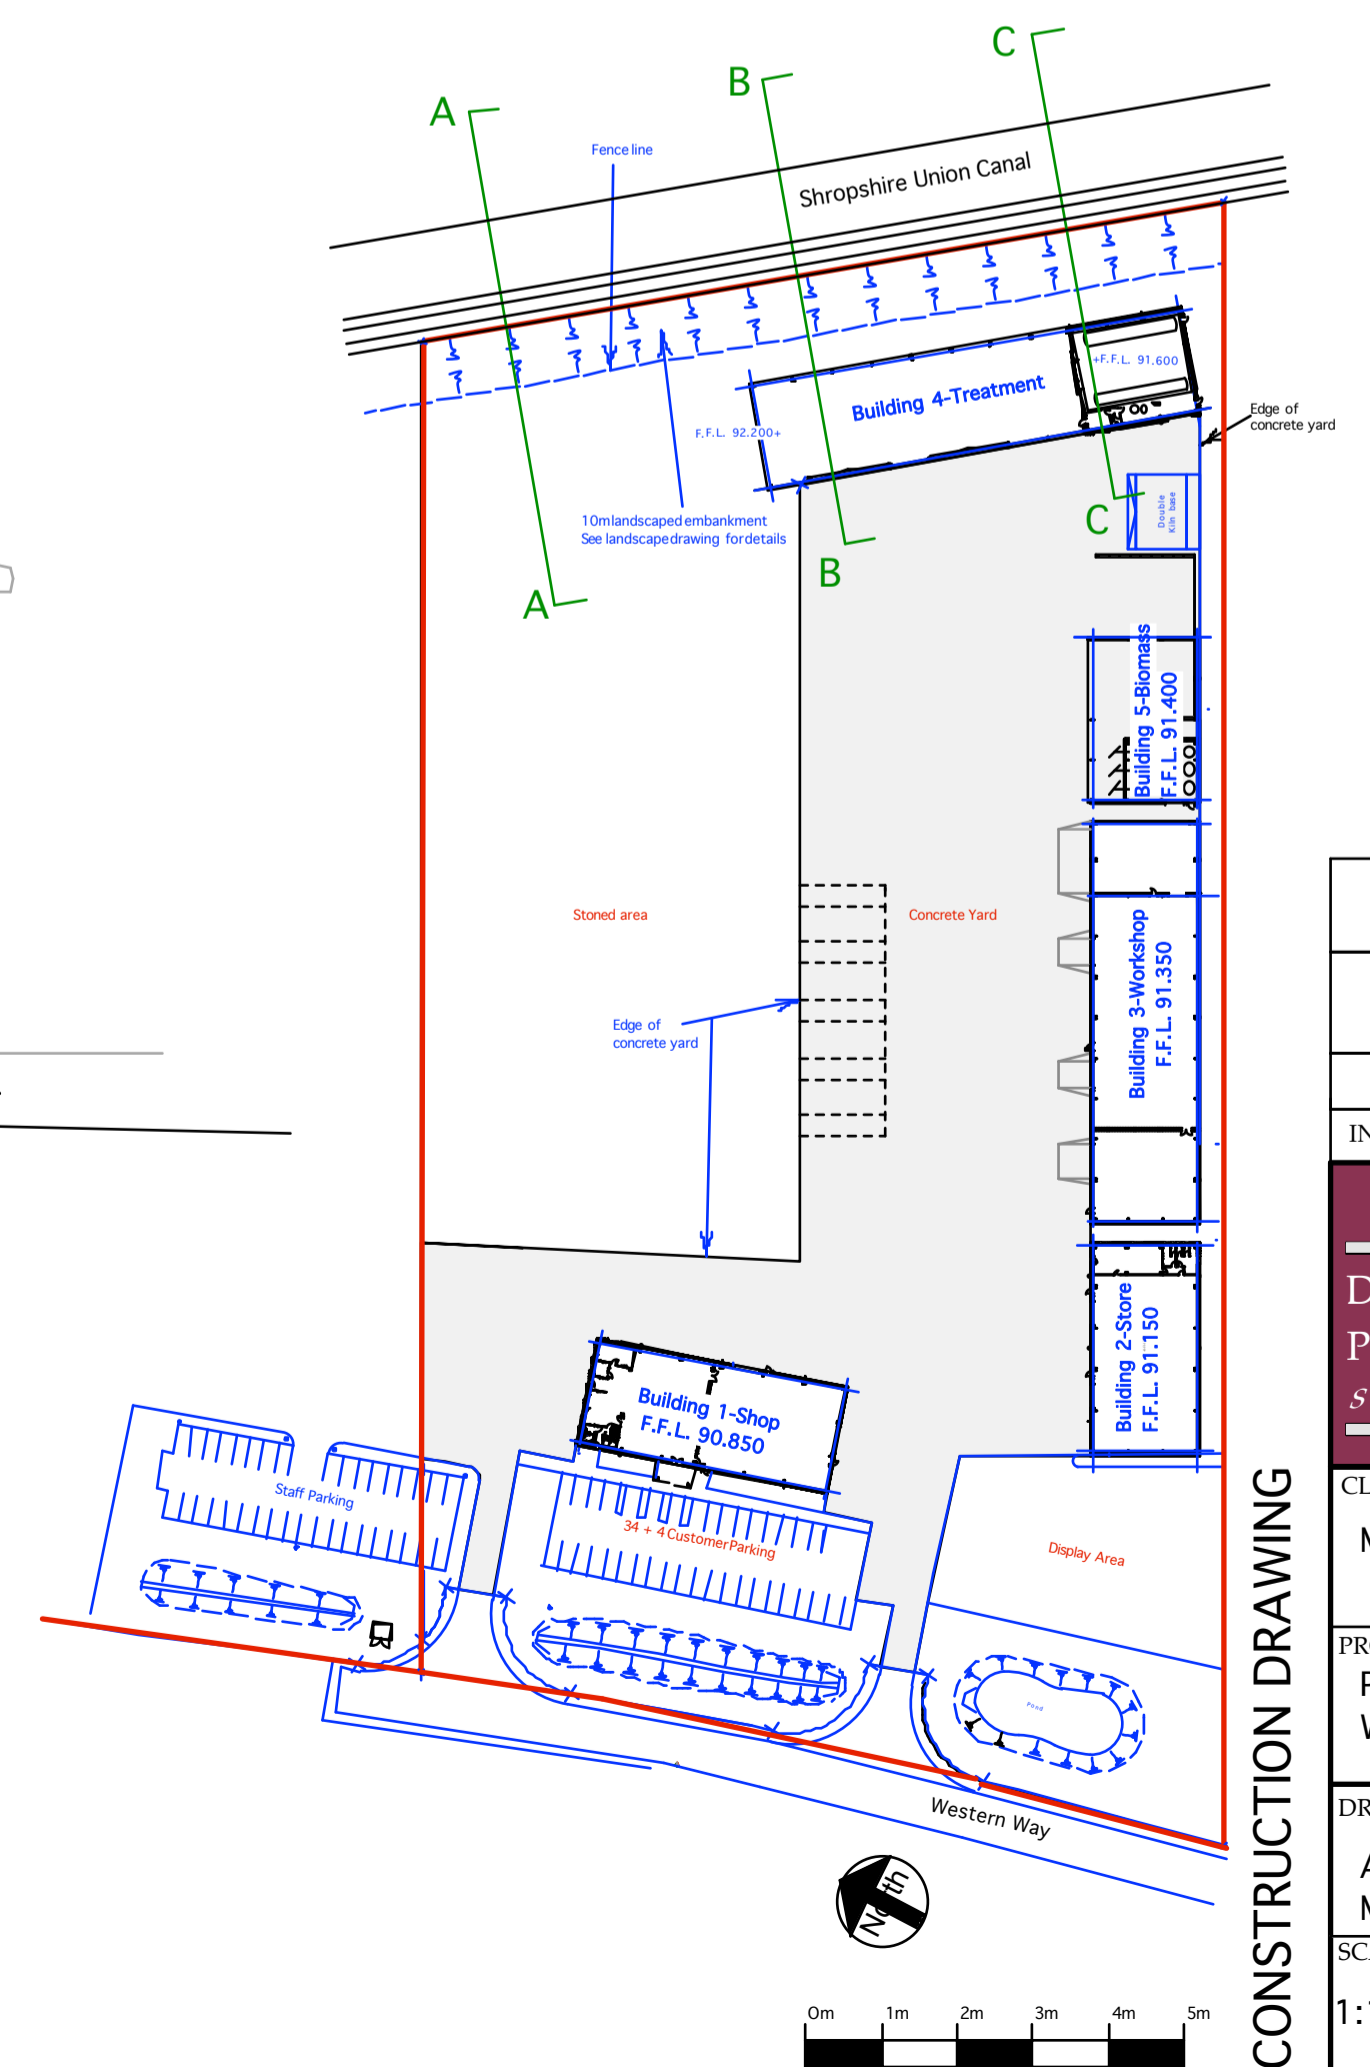

**PRELIMINARY**

INDEX	DATE	INITIAL	REVISION
A	06.11.14	J.M.R.	ACOUSTIC FENCE ADDED

**DEVELOPMENT PROJECT services**  
Architects, Project Managers, Development Consultants  
The Westlands  
132 Compton Road,  
Wolverhampton WV3 9QB.  
Tel: (01902) 427067  
Fax: (01902) 712070

CLIENT McPhillips (Wellington) Ltd			
PROJECT Proposed Development for Hales Sawmills Western Way Market Drayton			
DRAWING TITLE As Built Sections Through Mound		DRAWN BY J.M.R.	
SCALE 1:100@A1	DATE 09.09.14	DRG. NO. 2072-121	REVISION A